



LOCATION MAP FOR THE  
 GAS COLLECTION AND CONTROL SYSTEM  
 NEAL ROAD SANITARY LANDFILL  
 BUTTE COUNTY, CALIFORNIA

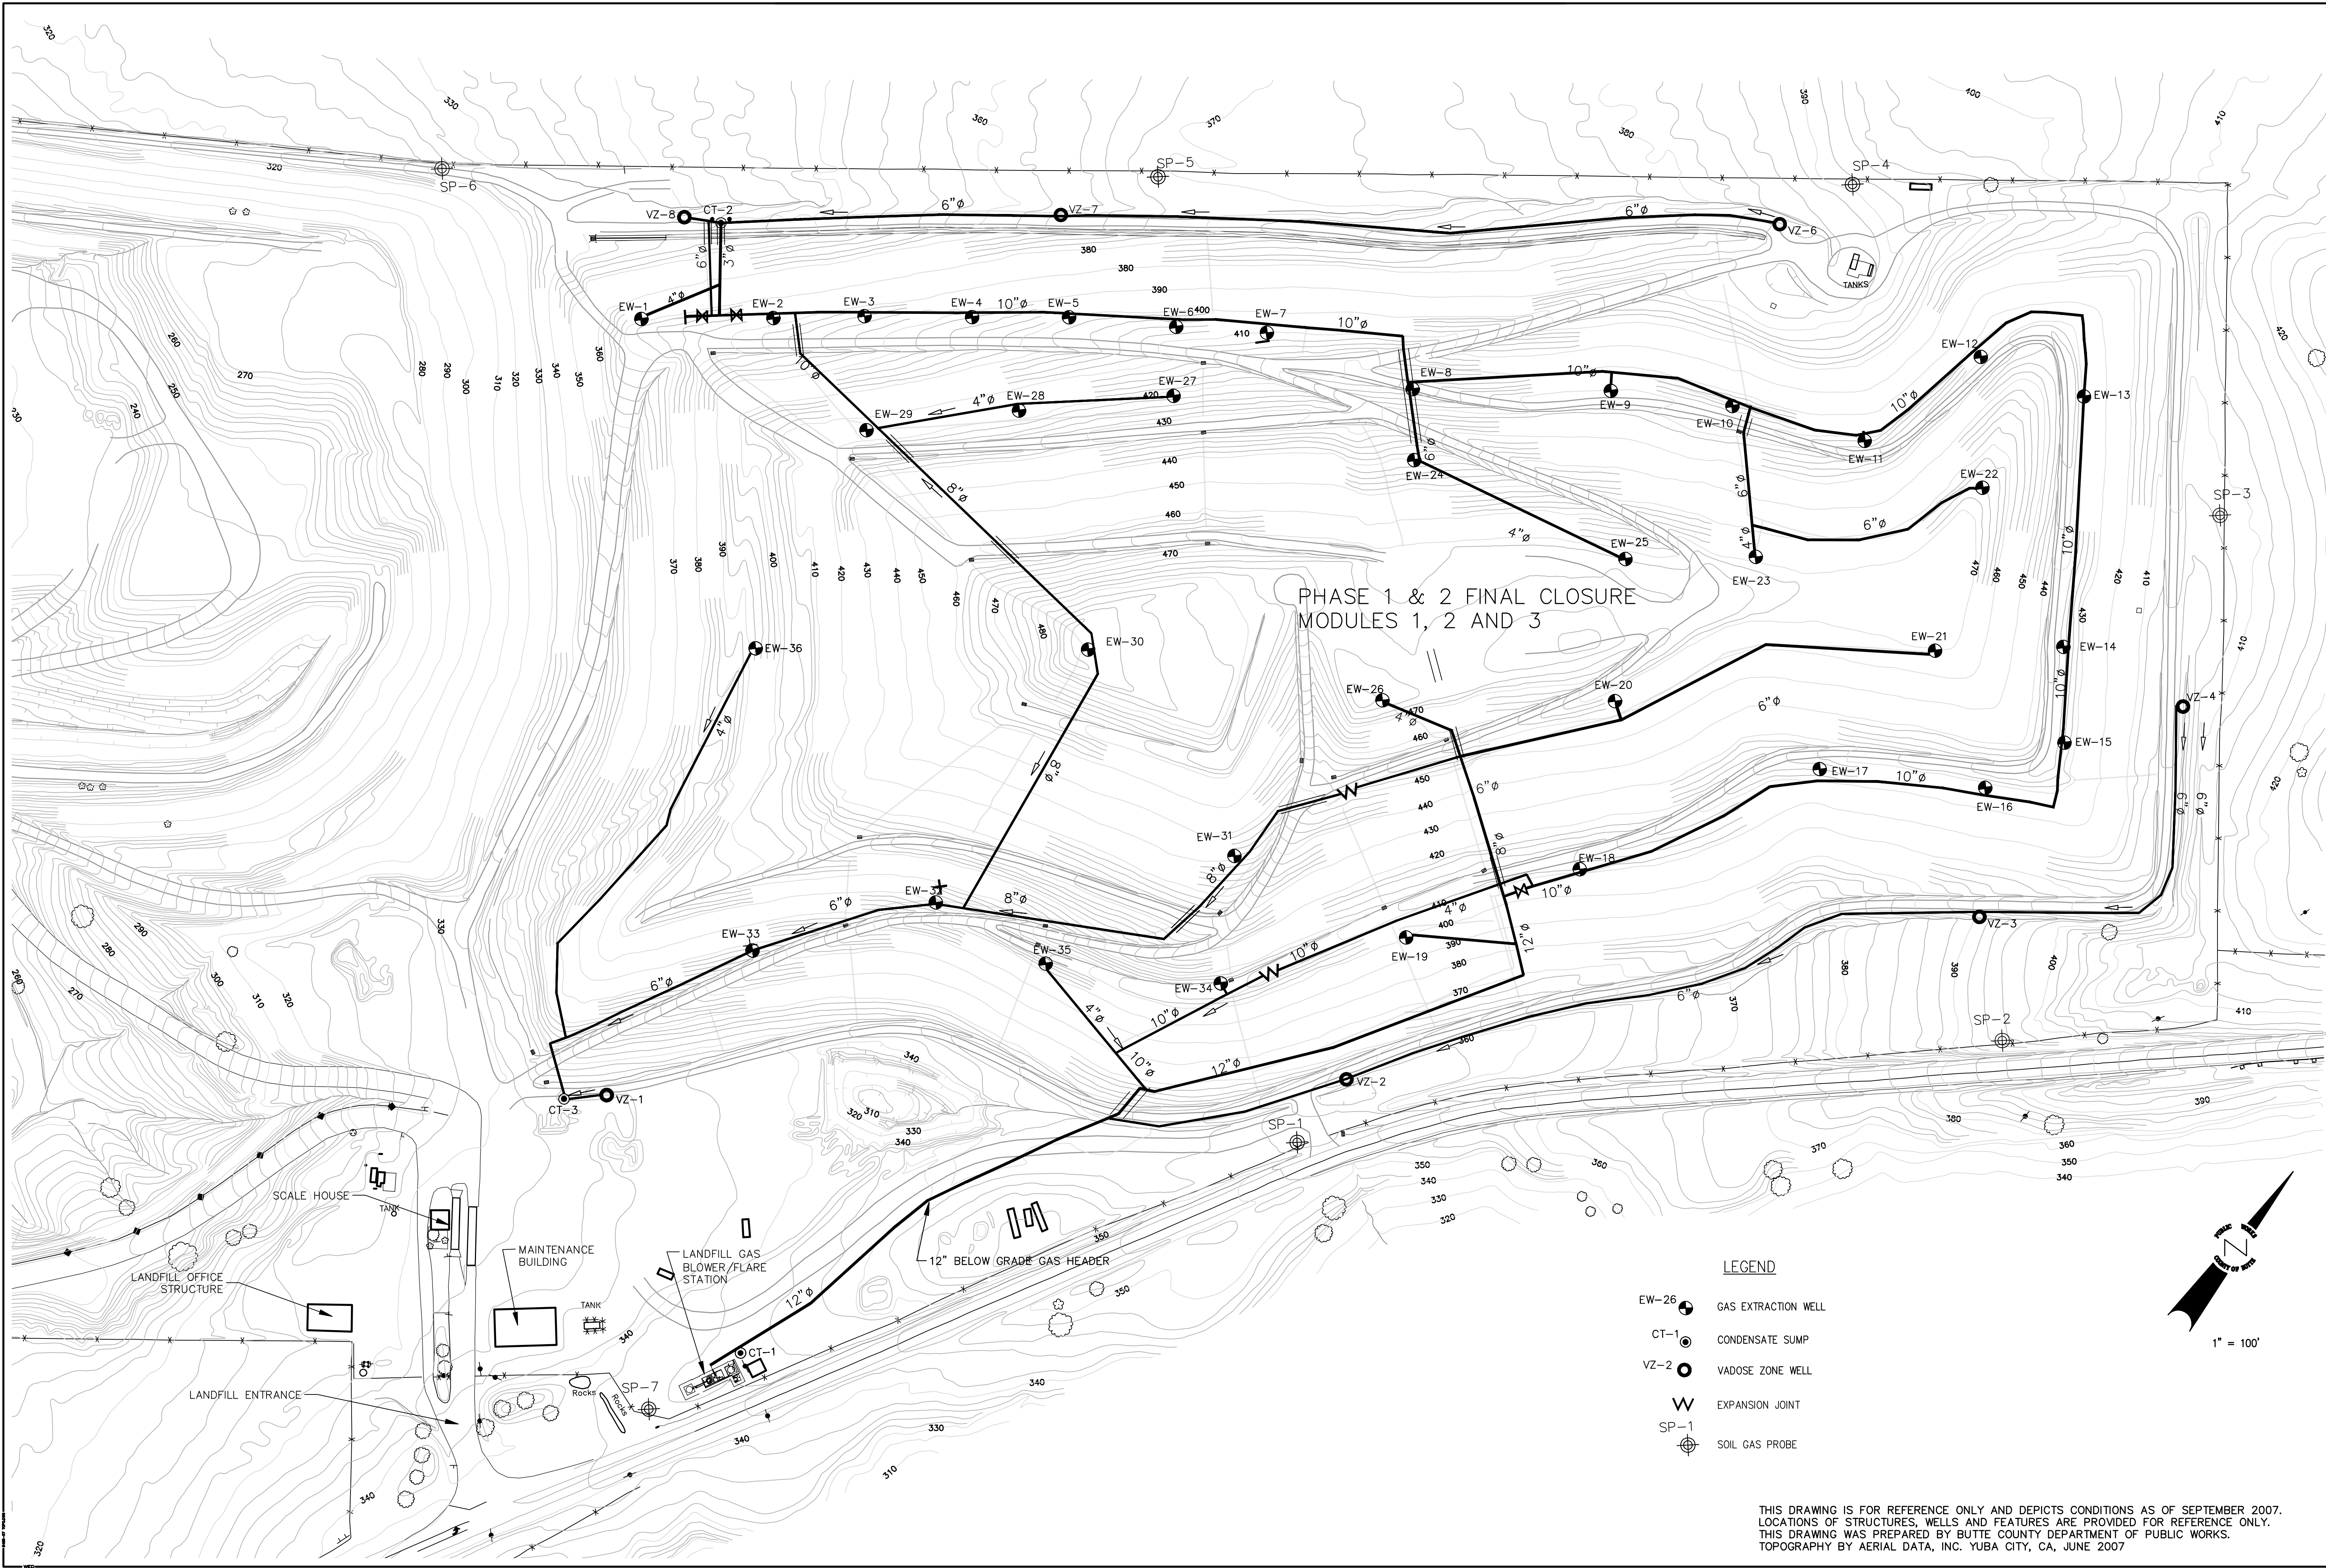

PHASE 1 & 2 FINAL CLOSURE  
 MODULES 1, 2 AND 3

LEGEND

- EW-26 ● GAS EXTRACTION WELL
- CT-1 ● CONDENSATE SUMP
- VZ-2 ● VADOSE ZONE WELL
- W EXPANSION JOINT
- SP-1 ● SOIL GAS PROBE

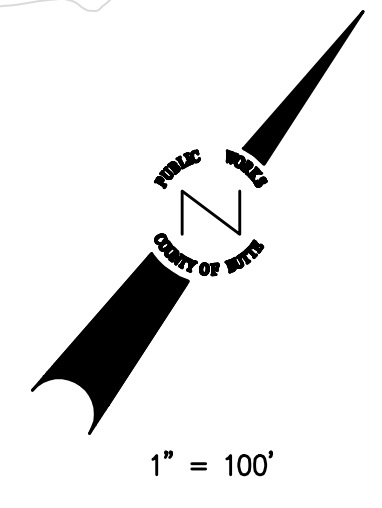

THIS DRAWING IS FOR REFERENCE ONLY AND DEPICTS CONDITIONS AS OF SEPTEMBER 2007.  
 LOCATIONS OF STRUCTURES, WELLS AND FEATURES ARE PROVIDED FOR REFERENCE ONLY.  
 THIS DRAWING WAS PREPARED BY BUTTE COUNTY DEPARTMENT OF PUBLIC WORKS.  
 TOPOGRAPHY BY AERIAL DATA, INC. YUBA CITY, CA, JUNE 2007